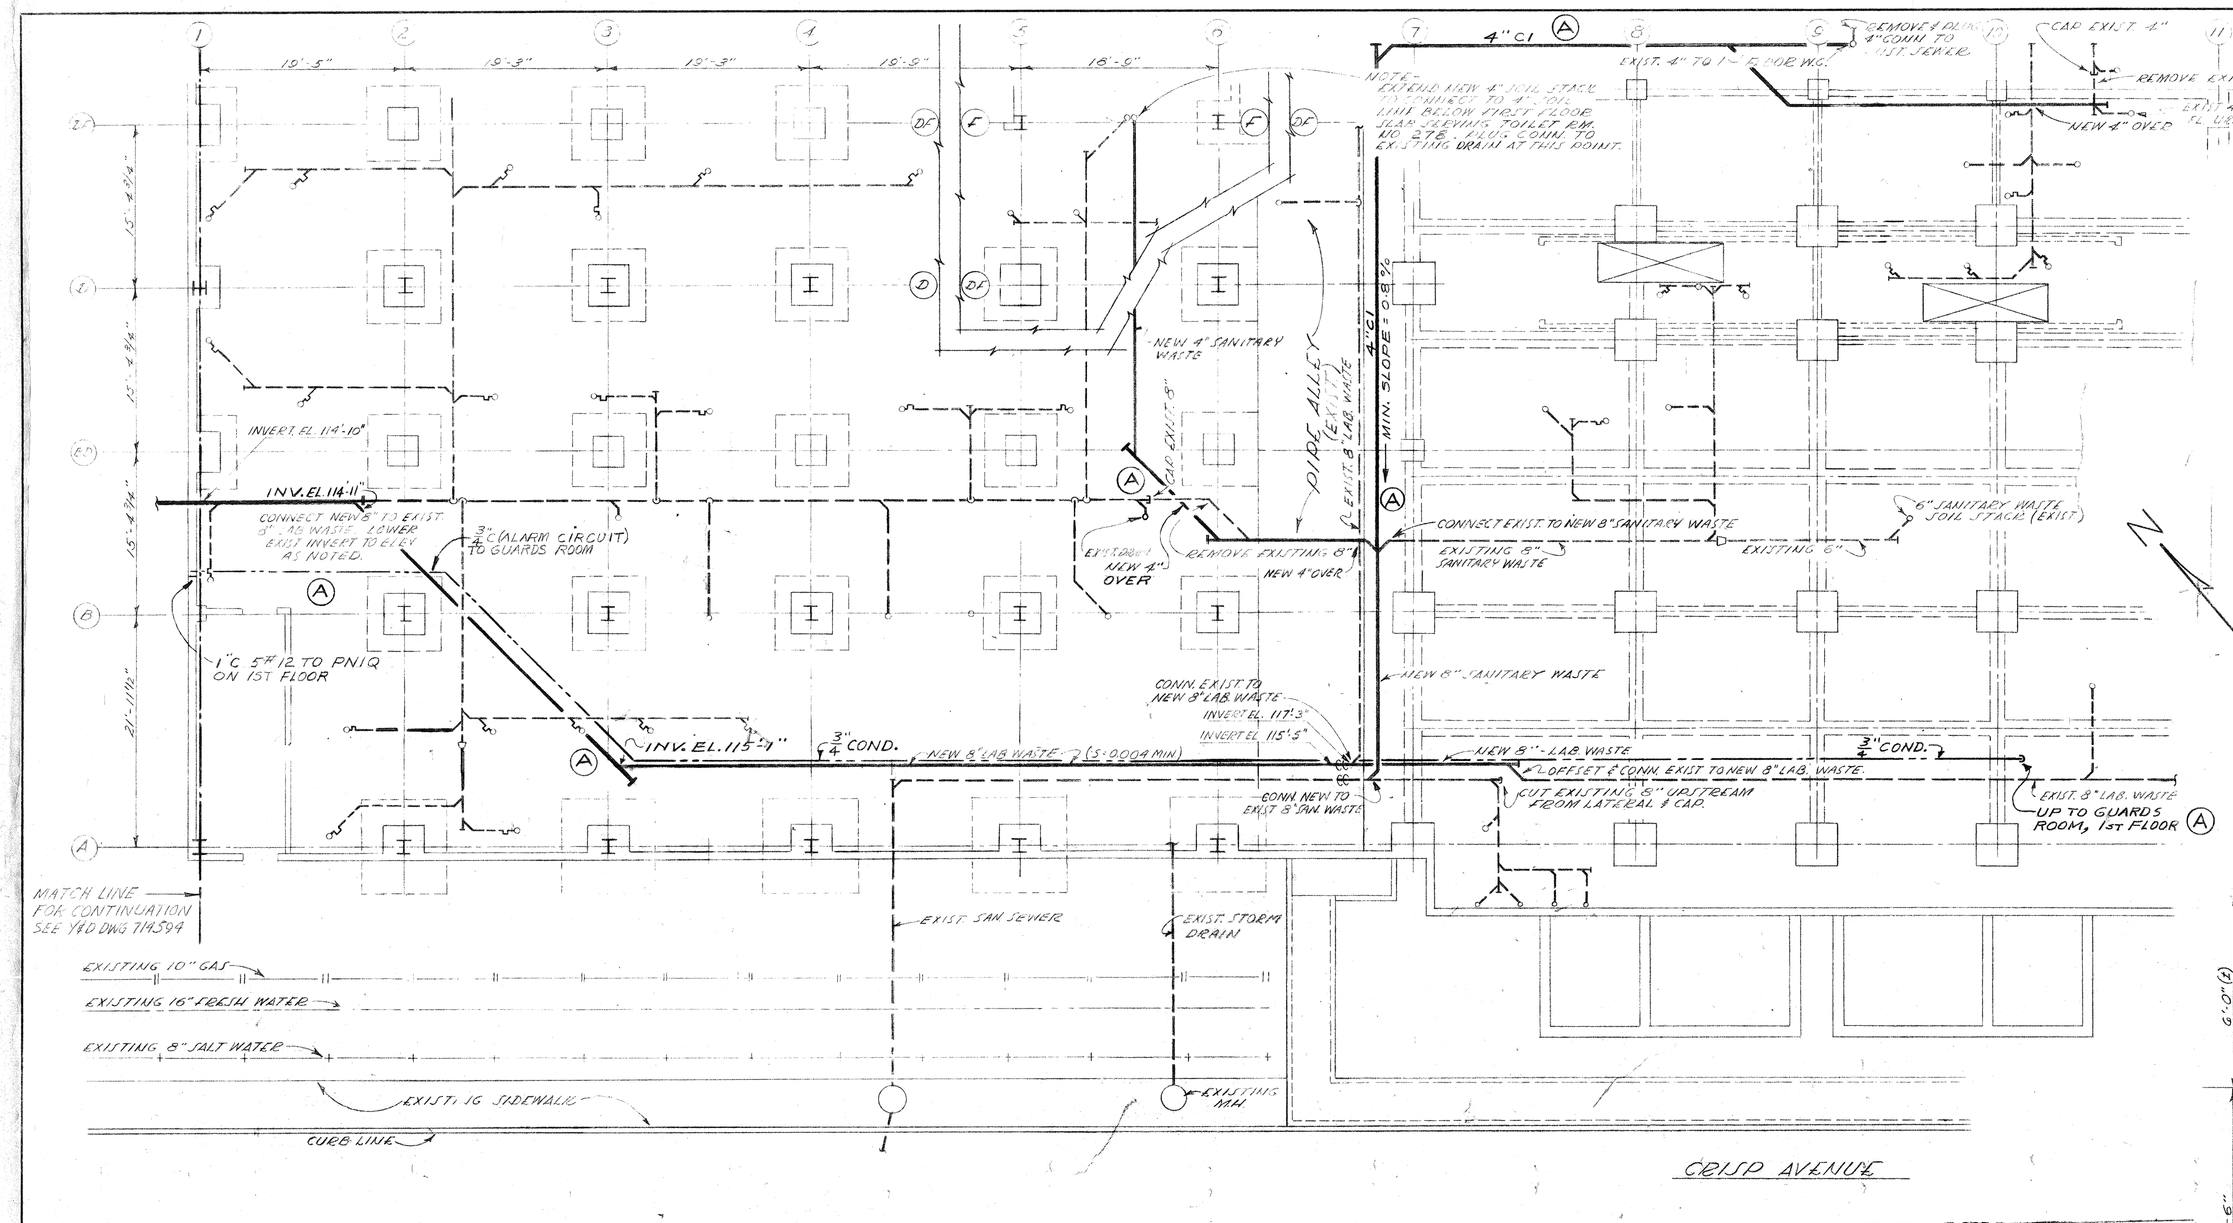

PLAN - BASEMENT WEST & CENTER
SCALE: 1/8" = 1'-0"

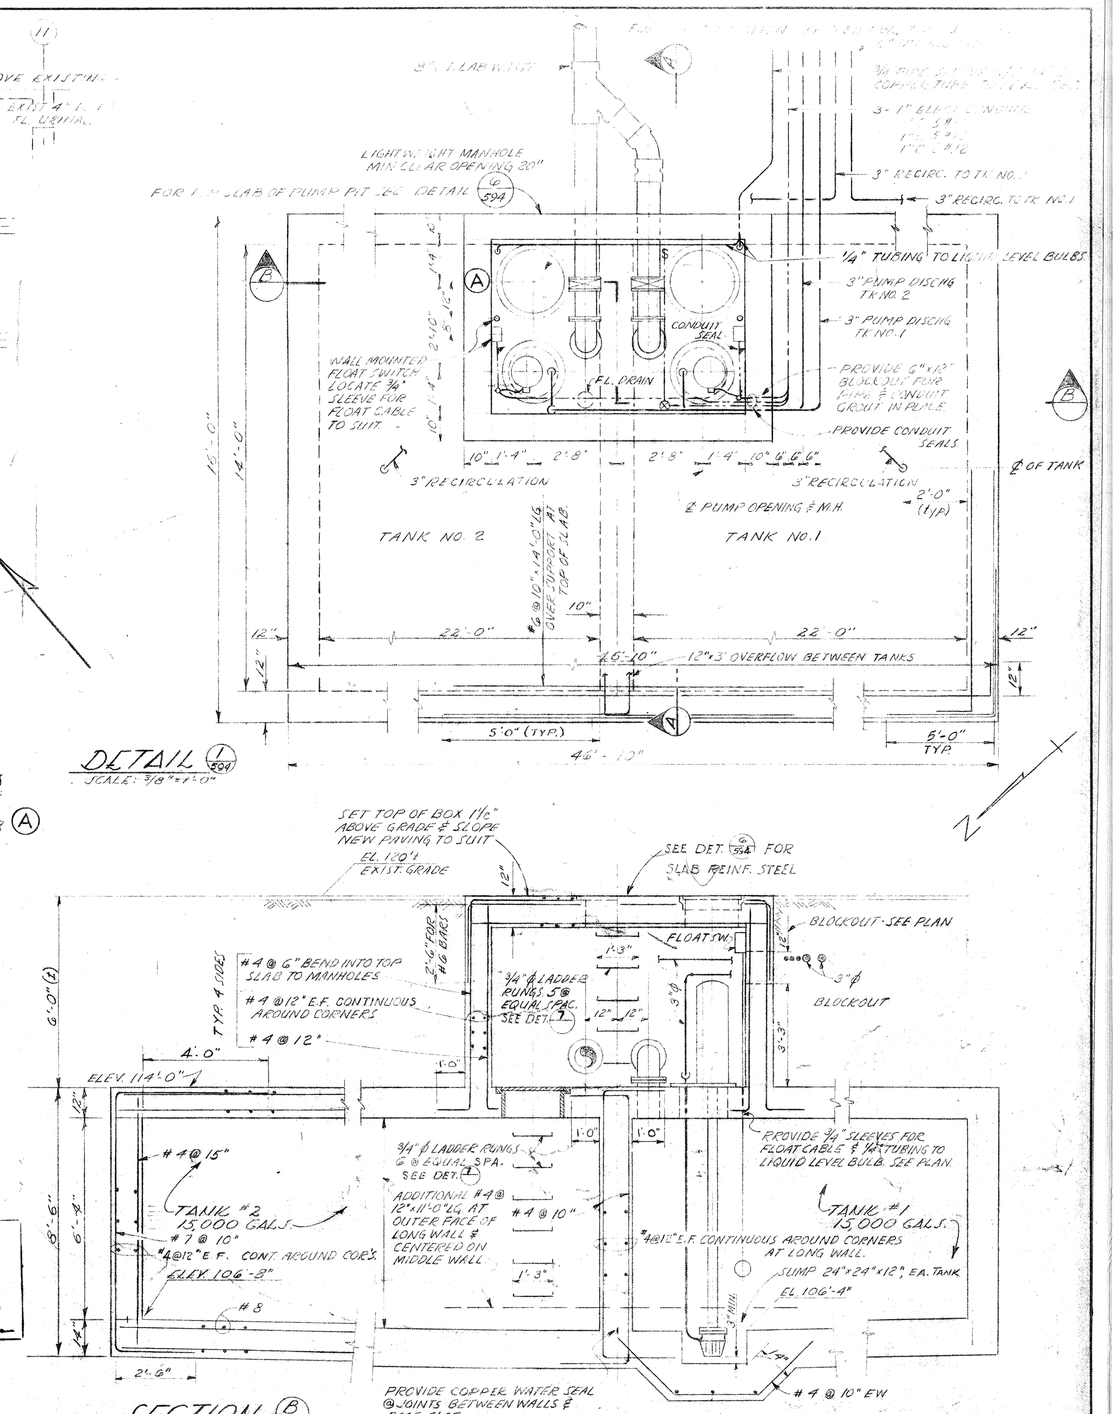


SECTION B
SCALE: 3/8" = 1'-0"

RECORD DRAWING
SHEET 1 OF 2
DATE LAST MOD. 18/126 DATE 2/15/60

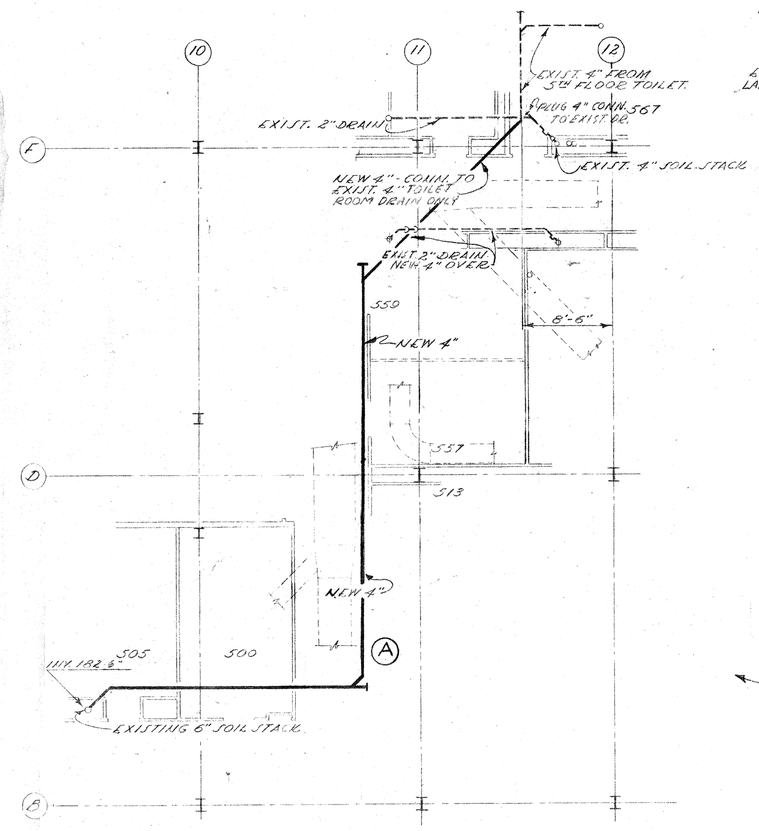

PLAN - BELOW 5TH FLOOR
SCALE: 1/8" = 1'-0"

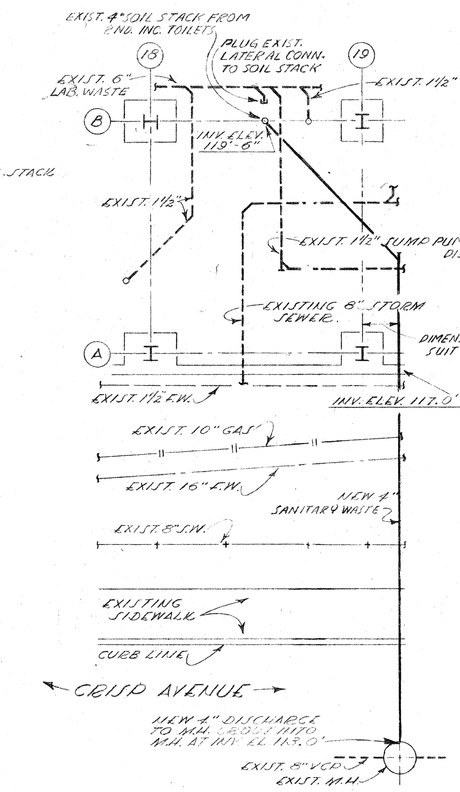

PLAN - BASEMENT 2ND INCREMENT
SCALE: 1/8" = 1'-0"

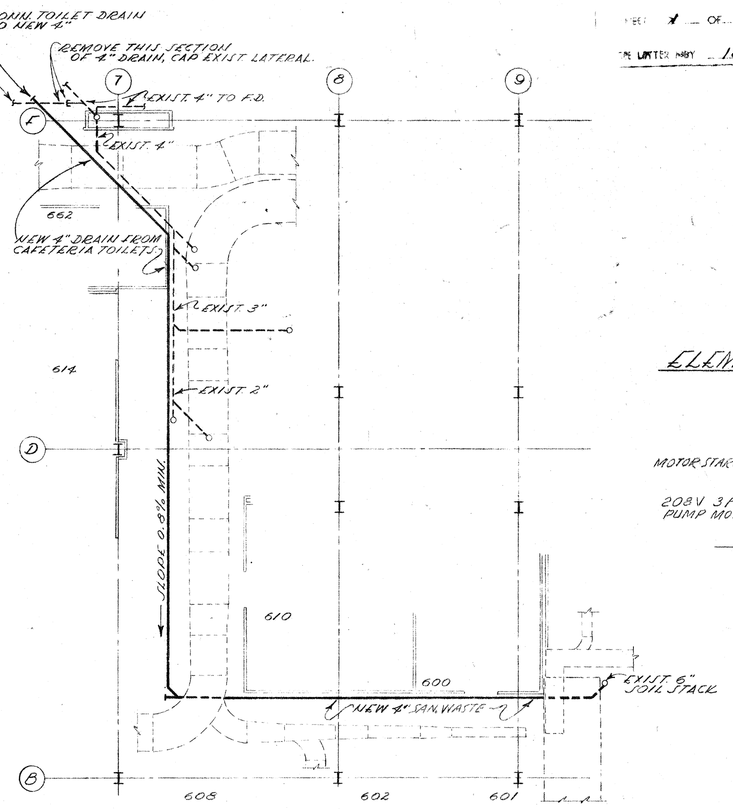

PLAN - 6TH FLOOR CENTER BELOW ROOF
SCALE: 1/8" = 1'-0"

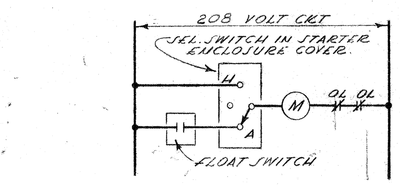

ELEMENTARY WIRING DIAGRAM
SUMP PUMPS

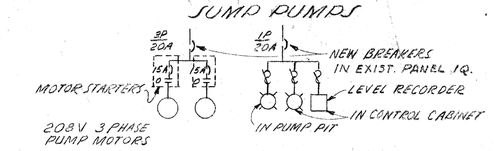

ONE LINE DIAGRAM

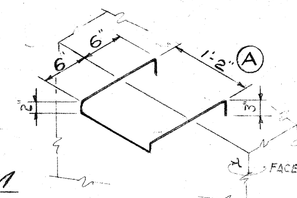

DETAIL 1
NO SCALE

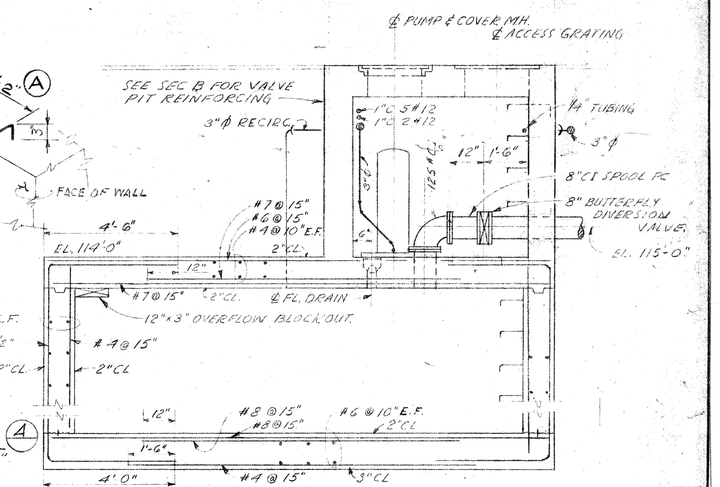

SECTION A
SCALE: 3/8" = 1'-0"

NOTES

1. LAP REBARS 30 DIA UNLESS NOTED.
2. REINFORCING STL. 60,000 PSI INTERMEDIATE GRADE.
3. LAB. WASTE SYSTEM TO SERVE ALL BLDG DRAINS EXCEPT TOILETS.
4. ELEV'S. OF ALL EXIST. PIPING TO BE VERIFIED IN FIELD.
5. EXIST. GAS & WATER PIPING IS PROVIDED W/ CATHODIC PROTECTION.
6. CONC. SHALL DEVELOP 3000 PSI COMPRESSIVE STRENGTH IN 28 DAYS.

GRAPHIC SCALE

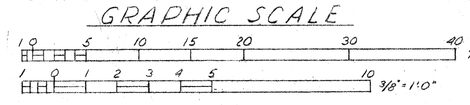

LEGEND

- EXIST. BLDG. PIPING
- NEW DRAIN & PUMP PIPING
- NEW ELECT. CONDUIT

SYMBOL	DESCRIPTION	DATE	APPROVAL
A	REVISED AS BUILT	12-11-59	

REVISIONS

DEPARTMENT OF THE NAVY
DISTRICT PUBLIC WORKS OFFICE
BUREAU OF YARDS & DOCKS
12TH ND SAN BRUNO, CALIF.

ARCHITECT - ENGINEER: KAISER ENGINEERS, DIVISION OF HENRY J. KAISER COMPANY — KAISER BLDG., OAKLAND

DR. BY: [illegible] 5-18-58
CHECKED BY: [illegible] 5-22-58
APP'D: FLH 5-28-58
APP'D: [illegible] 5-29-58
SPEC. CHK.: [illegible]
SAN. ENG.: [illegible]
ENG. IN CHG.: [illegible]
DIR. DES.: [illegible]
DPWO DRAWING NO. B-52873

SAN FRANCISCO NAVAL SHIPYARD
SAN FRANCISCO, CALIFORNIA

FACILITIES TO CONTROL & MONITOR RADIOACTIVE CONTAMINATION IN LABORATORY WASTES
U.S. NAVAL RADIOLOGICAL DEFENSE LABORATORY
LABORATORY & SANITARY WASTE SEGREGATION - PLAN & DETAILS

SUBMITTED BY: KAISER ENGINEERS, DIVISION OF HENRY J. KAISER CO.
DATE: [illegible] — SIGNATURE & TITLE: [illegible] RESIDENT ENGINEER

APPROVED: [illegible] DATE: 6/5/58
RESIDENT OFFICER IN CHARGE (A & E CONTRACT)

SATISFACTORY TO: [illegible]
SIGNATURE: [illegible]
DATE: 6/2/58 TITLE: Compt. & Mgt. Eng.

APPROVED FOR BUREAU OF YARDS & DOCKS: [illegible]
FOR DPWO FOR CHIEF OF BUREAU
DATE: 6/5/58

SCALE: AS NOTED — SPEC. (REV.) [illegible]
SHEET 1 OF 2 NBy 18126
Y & D DRAWING NO. 7245