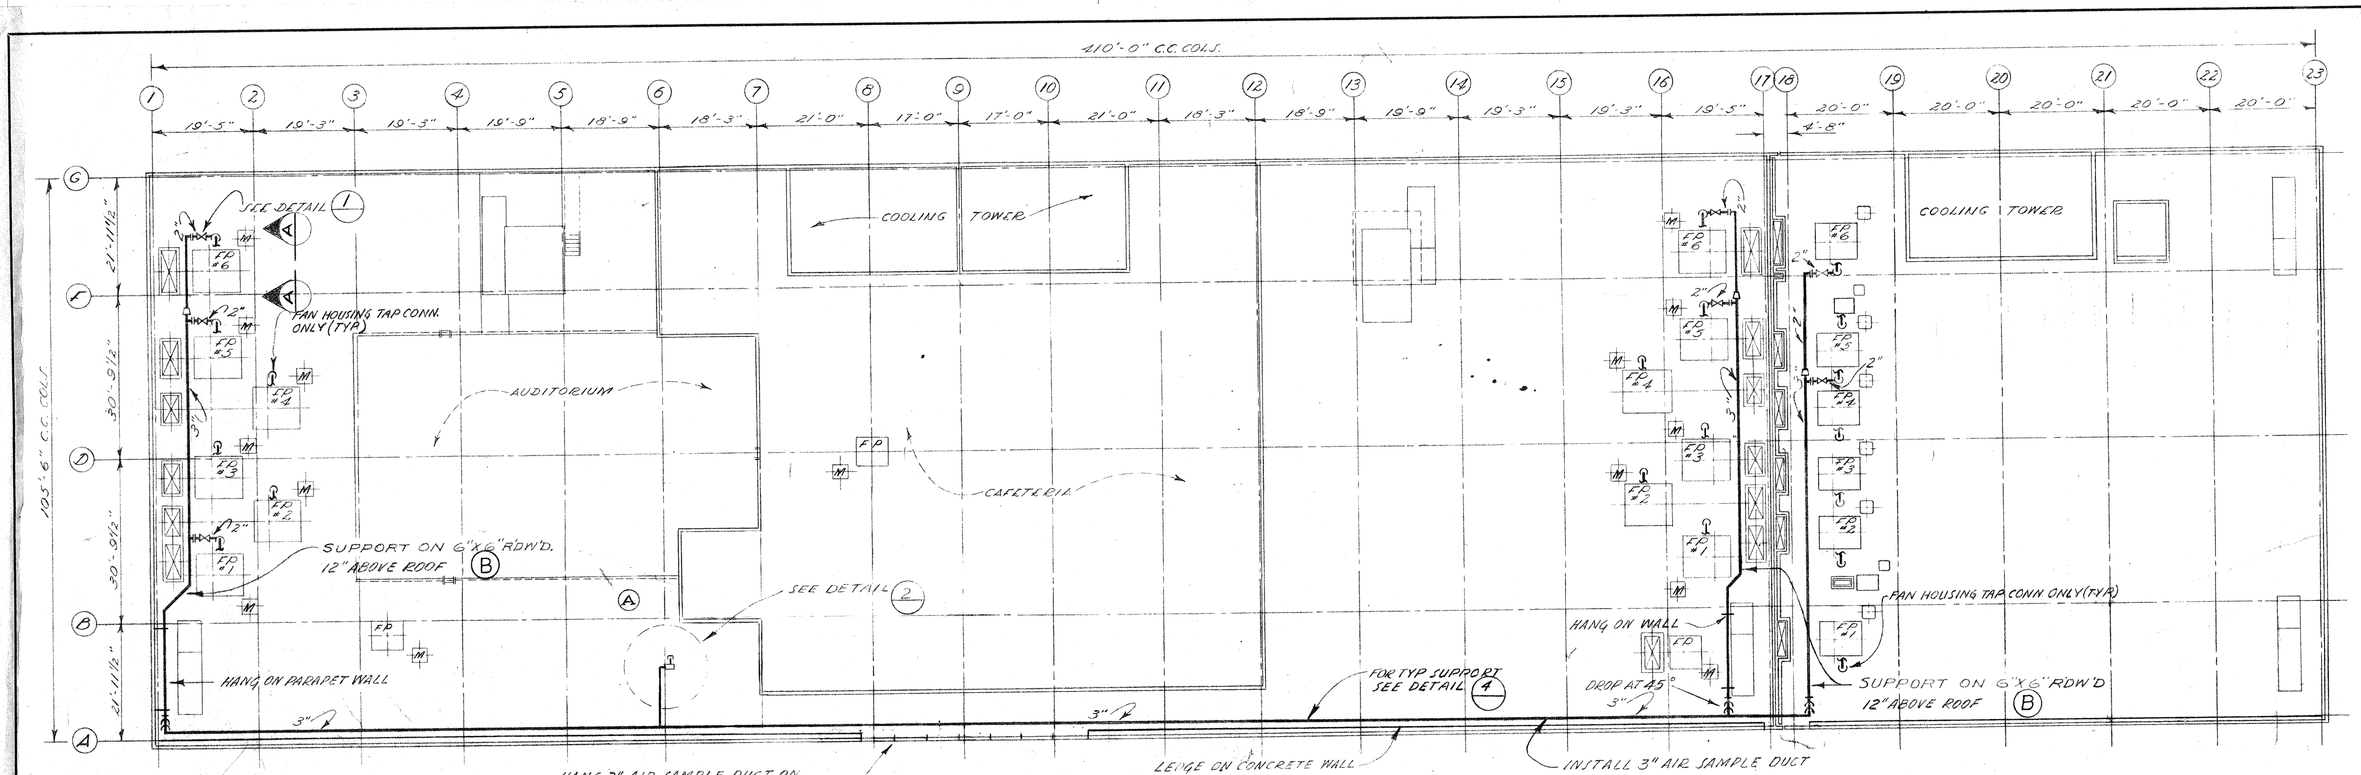

(WEST, CENTER, EAST & 2ND INCREMENT)

ROOF PLAN
SCALE: 1/16" = 1'-0"

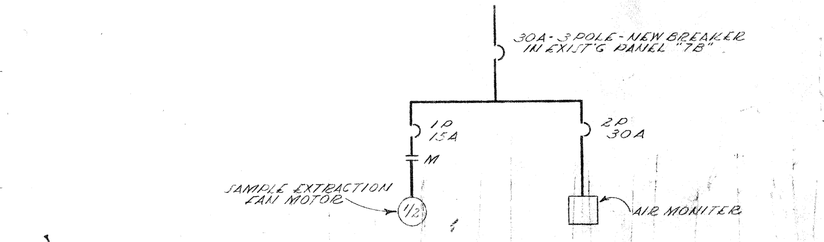

ONE LINE DIAGRAM

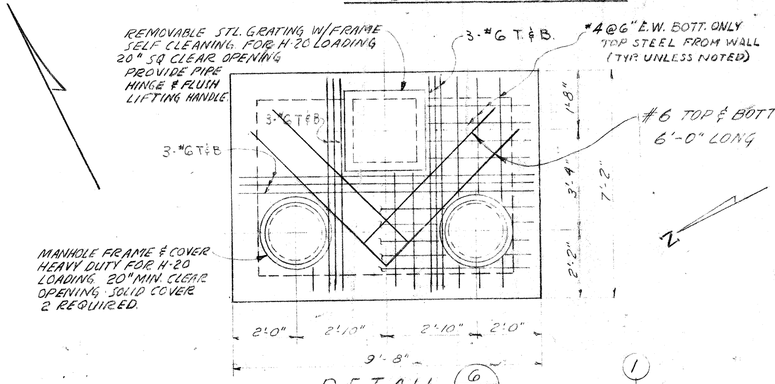

DETAIL 6/593

PLAN OF PUMP PIT SLAB
SCALE 3/8" = 1'-0"

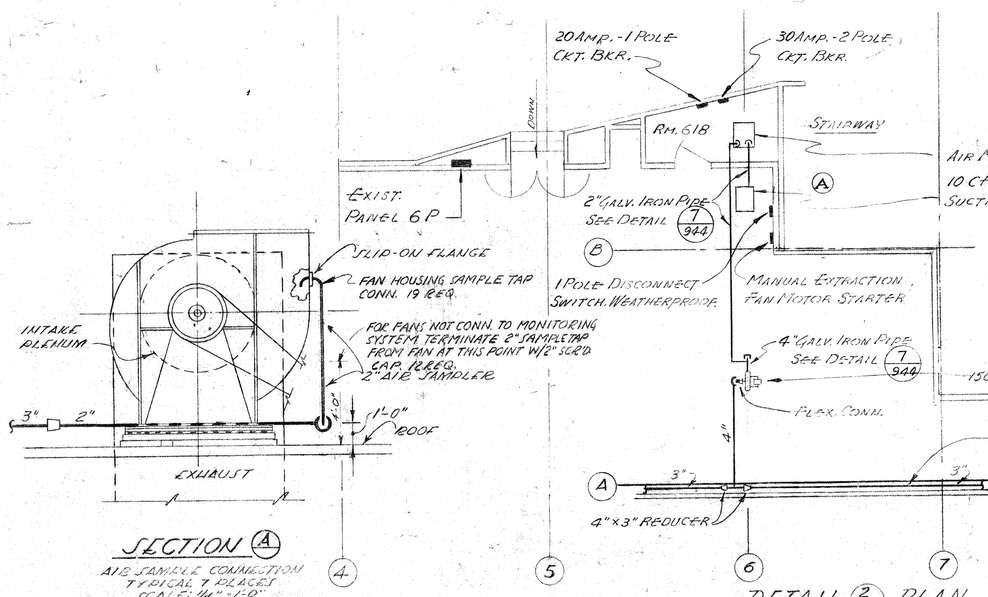

AIR SAMPLE CONNECTION TYPICAL 7 PLACES
SCALE: 1/4" = 1'-0"

DETAIL 2 PLAN
SCALE 1/8" = 1'-0"

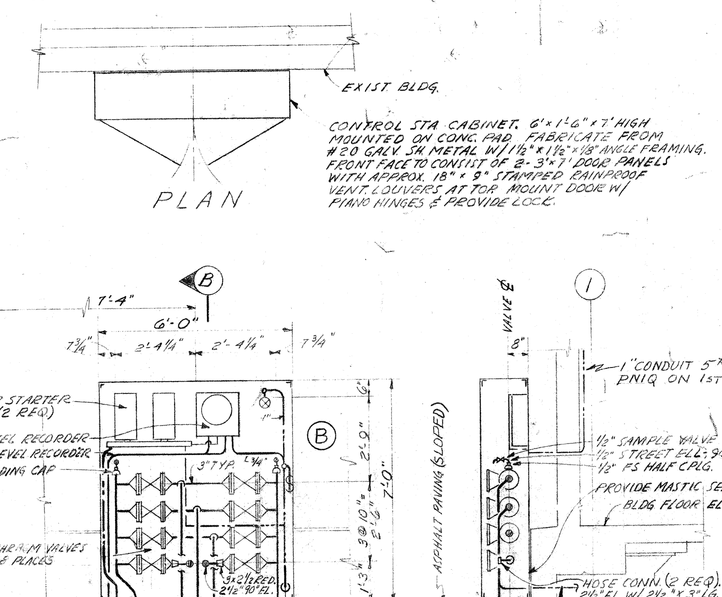

PLAN

ELEVATION

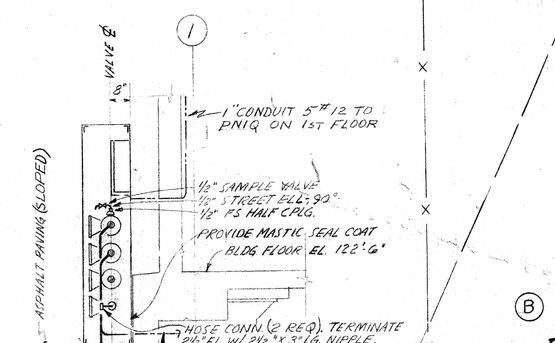

SECTION B

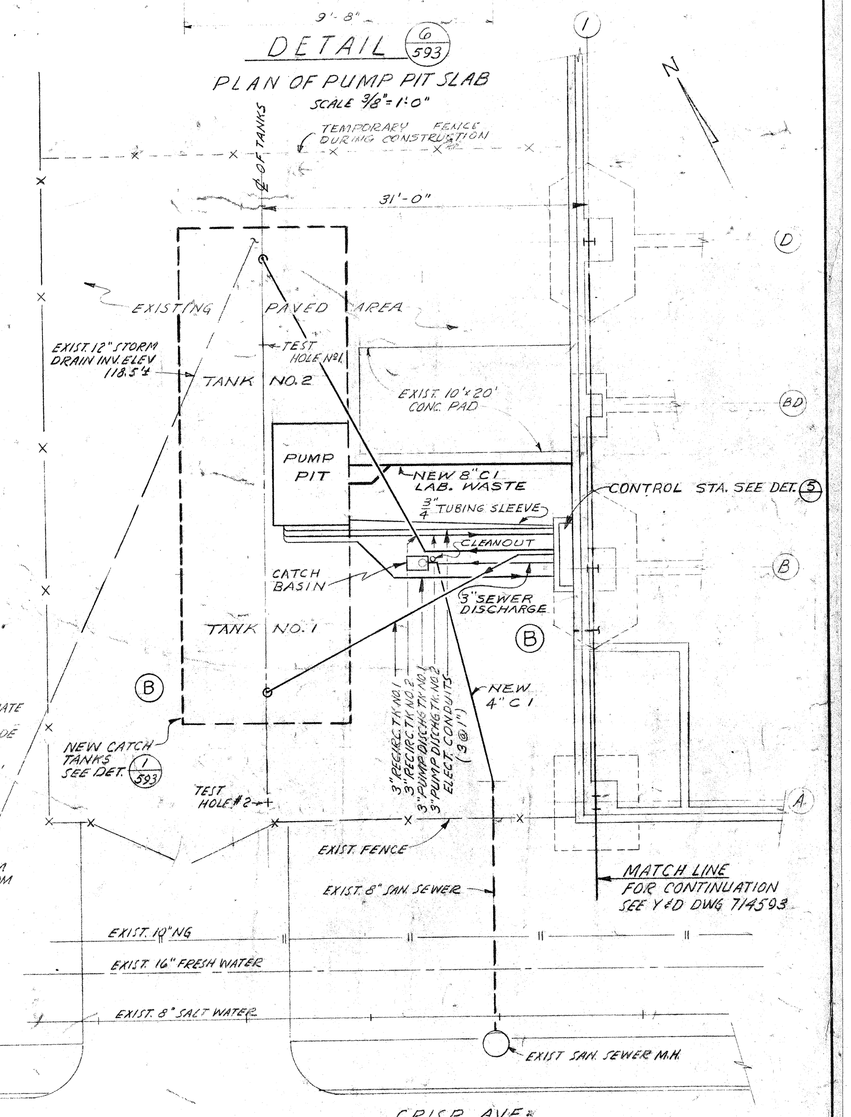

PLAN AT CATCH TANKS
SCALE 1/8" = 1'-0"

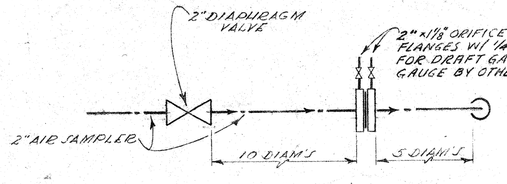

DETAIL 1
SHUT-OFF & METERING STA. TYPICAL 7 PLACES
NO SCALE

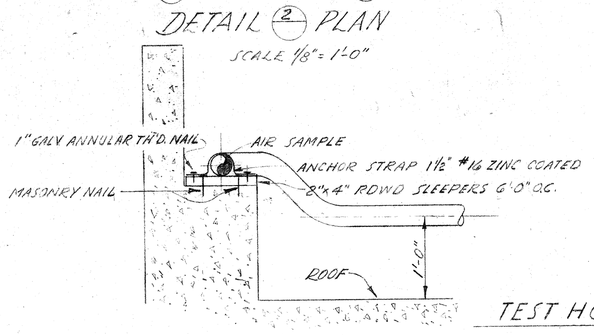

DETAIL 4
SCALE 1" = 1'-0"

TEST HOLE LOGS

DEPTH	HOLE NO. 1	DEPTH	HOLE NO. 2
	120.3'± GRADE ELEV.		120.0'±
	ASPHALT PAV. GRAVEL FILL		ASPHALT PAV. GRAVEL FILL
2	BROKEN SERPENTINE FILL	2	
4	BROKEN SERPENTINE & BROWN CLAY FILL	4	
6	BROKEN SERPENTINE FILL	6	MIXTURE OF BROWN & GRAY SERPENTINE FILL
8	SERPENTINE FILL	8	
10		10	
12	SAND & BROKEN SERPENTINE FILL	12	
14		14	WATER TABLE
16	WATER TABLE HARD SERPENTINE	16	SOFT GRAY SERPENTINE FILL
18		18	
	SAND		
20		20	FLUID, GRAY SERPENTINE GOUGE
22	BROWN SANDSTONE & SERPENTINE	22	FIRM SERPENTINE

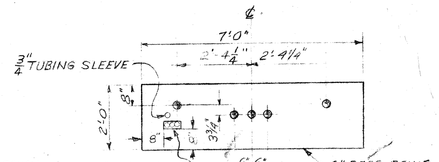

PLAN
CONCRETE PAD B
NOTE: PENETRATIONS FOR 3" PIPE EXCEPT AS NOTED

DETAIL 5
SCALE 3/8" = 1'-0"
CONTROL STATION

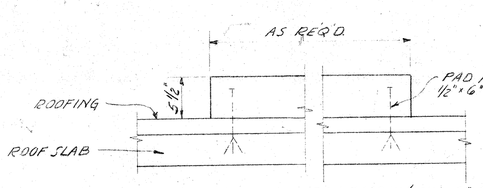

1- CONC. PAD WILL BE SIZED TO SUIT FAN BASE W/MIN. 4" CLEARANCE TO EDGE OF PAD.
2- PROVIDE ANCHOR BOLTS IN PAD TO SUIT FAN.

DETAIL 3
EQUIPMENT PAD
SCALE 1" = 1'-0"

GRAPHIC SCALE

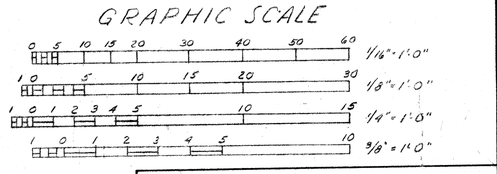

REV. A AMENDMENT No. 1 CHANGE ORDER No. — TO NBy 18126

SYMBOL	DESCRIPTION	DATE	APPROVAL
B	REVISED AS BUILT	12-11-59	
A	REVISED BY JAUST AIR MONITORING SYSTEM	7/9/59	

REVISIONS

DEPARTMENT OF THE NAVY
DISTRICT PUBLIC WORKS OFFICE
ARCHITECT - ENGINEER

KAISER ENGINEERS
DIVISION OF HENRY J. KAISER COMPANY

BUREAU OF YARDS & DOCKS
12 TH NO SAN BRUNO, CALIF
KAISER BLDG., OAKLAND

DR. BY JT 4-21-58
CHECKED BY JR 4-21-58
APP'D FLH 5-28-58
APP'D 5-28-58
SPEC. CH'K. HEKEFT
SAN. ENG. 1
ENG. IN CHG. SCHNELL
DIR. DES. O'CONNOR
DPWO DRAWING NO. B-52814

SAN FRANCISCO NAVAL SHIPYARD
SAN FRANCISCO, CALIFORNIA
FACILITIES TO CONTROL & MONITOR RADIOACTIVE CONTAMINATION IN LABORATORY WASTES
U.S. NAVAL RADIOLOGICAL DEFENSE LABORATORY
EXHAUST AIR MONITORING
PLAN & DETAILS

APPROVED — DATE 6/5/58
RESIDENT OFFICER IN CHARGE (A & E CONTRACT)

RECORD DRAWING
SHEET 2 OF 2
NO. 18126 DATE 2/16/60

SUBMITTED BY KAISER ENGINEERS
DIVISION OF HENRY J. KAISER CO.
DATE 5-28-58 SIGNATURE & TITLE — VICE-PRESIDENT
SATISFACTORY TO
SIGNATURE
DATE 6/17/58 TITLE Compt. & Mat. Eng.

APPROVED FOR BUREAU OF YARDS & DOCKS
FOR DPWO FOR CHIEF OF BUREAU
DATE 6/5/58

SCALE AS NOTED
SPEC (REV.) 4/20/59
SHEET 2 OF 2 NBy 18126
Y & D DRAWING NO. 714592