REVISIONS			
SYM	DESCRIPTION	DATE	APPROVED
1	AS BUILT	4-20-67	

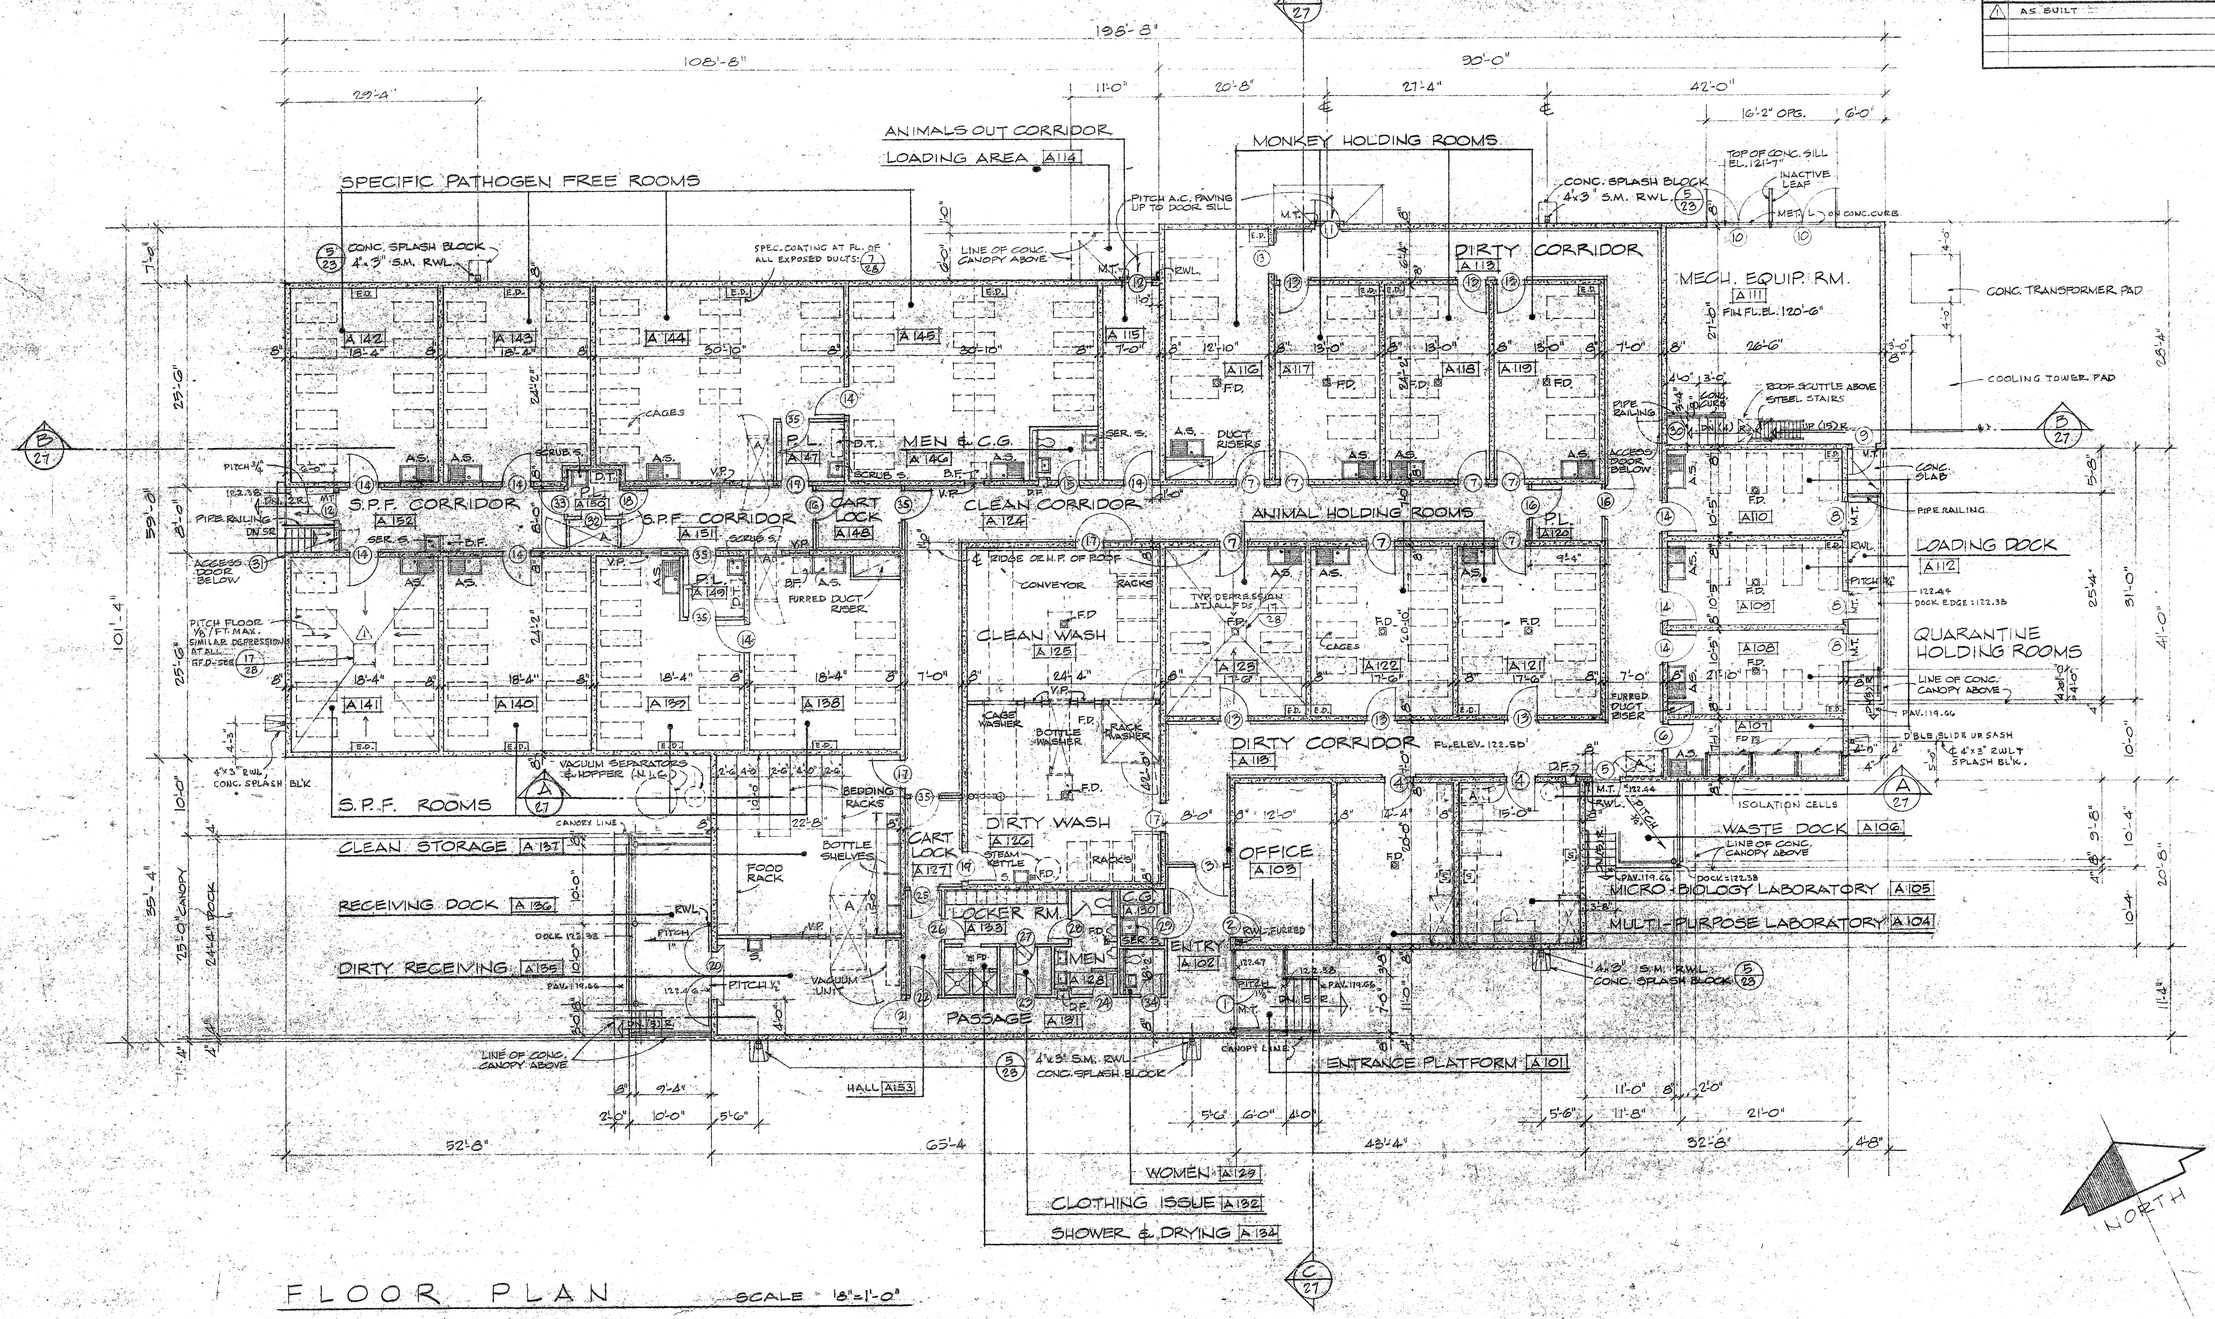

FLOOR PLAN

SCALE 1/8"=1'-0"

KEY TO ABBREVIATIONS

A.	AUTOCLAVE	N.I.C.	NOT IN CONTRACT
A.S.	ANIMAL SINK	L.P.	LOW POINT
B.F.	BOTTLE FILLER	H.P.	HIGH POINT
C.G.	CLEANING GEAR	A.C.	ASPHALTIC CONCRETE
D.F.	DRINKING FOUNTAIN	M.T.	METAL THRESHOLD
		H.M.	HOLLOW METAL
F.D.	FLOOR DRAIN	C.T.	CERAMIC TILE
P.L.	PERSONNEL LOCK	M.L.	METAL LATH
RWL.	RAIN WATER LEADER	S.S.	STAINLESS STEEL
S.	SINK	G.D.	GUTTER DRAIN
SER. S.	SERVICE SINK	C.L.	CHAIN LINK
S.P.F.	SPECIFIC PATHOGEN FREE	P.M.	PROTECTED METAL
S.M.	SHEET METAL	H.R.	HAND RAIL
V.P.	VISION PANEL	R.D.	ROOF DRAIN
FFD	FUTURE FLOOR DRAIN	S.D.	SHOWER DRAIN
E.D.	EXHAUST DUCT	K.C.	KEENES CEMENT

ARCHITECTURAL SYMBOLS

- CONCRETE
- PLASTER ON MET. STUDS OR CHANNELS
- ASPHALTIC CONCRETE PAVING
- ROCK
- INSULATION
- (C / 27) — SECTION MARK — LAST 2 NOS. OF Y & D DWG. NO. WHERE SECTION IS FOUND.
- (1 / 28) — DETAIL MARK — LAST 2 NOS. OF Y & D DWG. NO. WHERE DETAIL IS FOUND.
- A126 — ROOM OR SPACE NO.
- (7) DOOR MARK

GENERAL NOTES

ALL EQUIPMENT SHOWN DOTTED IS GOV'T. FURNISHED EQUIPMENT (G.F.E.)

IN ROOMS HAVING FLOOR DRAINS PITCH MAX. OF 1/8"/FT. TO 2'-9" SQ. DEPRESSION AT FLOOR DRAIN. PITCH THIS AREA 1/4"/FT.-SEE 17/28.

FURRING SHOWN BUT NOT PIPING - SEE 1/4" SCALE PLAN; Y & D DWG. NO. 984225 FOR TYPICAL EXPOSED & PLUMBING PIPING AND ANIMAL SINK INSTALLATIONS.

RECORD DRAWING
SHEET 2 OF 2
LETTER DATED 8/18/67

J. FRANCIS WARD, A.I.A.
SAN FRANCISCO, CALIF.
ARCHITECT

DES JFW | DR GDH | CHK RWJ
SUPV | CH ENGR
SUBMITTED, BY — DATE 10/7/65
FIRM MEMBER-TITLE OWNER-A
ELEC. | MECH.
SOIL COND. | S.I.C.
STRL | DR
SANITARY-TITLE | DATE-10 NOV 65
TITLE | DATE-10 NOV 65

DEPARTMENT OF THE NAVY — BUREAU OF YARDS & DOCKS
DISTRICT PUBLIC WORKS OFFICE
TWELFTH NAVAL DISTRICT — SAN BRUNO, CALIFORNIA

U.S. NAVAL RADIOLOGICAL DEFENSE LABORATORY
SAN FRANCISCO, CALIFORNIA

RESEARCH ANIMAL FACILITY
BUILDING A*830 ARCHITECTURAL
FLOOR PLAN

CODE IDENT NO.	SIZE	DPWO-12 D'WG NO. B-65222
80091	F	Y & D DRAWING NO. 984222
SCALE 1/8"=1'-0"	SPEC 55440-64 NO. 55440	SHEET 2 OF 2

GRAPHIC SCALE 1/8"=1'-0"